

STATE OF UTAH
DEPARTMENT OF NATURAL RESOURCES
DIVISION OF OIL, GAS AND MINING
 1594 West North Temple - Suite 1210
 Box 145801
 Salt Lake City, Utah 84114-5801
 Telephone: (801) 538-5291
 Fax: (801) 359-3940

LARGE MINING OPERATIONS PROGRESS REPORT
January 1, 2010 to December 31, 2010

The information required in this form are based on provisions of the Mined Land Reclamation Act, Title 40-8, and the rules as under the Utah Minerals Regulatory Program.

1. Mine Permit Number: M / 450 / 006
2. Mine Name: Five Mile
3. Name of Operator/Permittee: Pabco Building Products LLC, dba Interstate Brick Company
 Note: If Operator's address, company representative or phone number have changed, please provide a replacement page to the Notice of Intention together with form MR-REV available on the Division's web page at https://fs.ogm.utah.gov/pub/mines/minerals_related/forms/MR-REV.pdf
4. Report the gross amount of ore mined and waste moved:
 Gross Ore Mined 0 Tons, or 0 yd³
 Waste Material Moved 0 Tons, or 0 yd³
5. Disturbance at end of 2010 0 Acres
 New Disturbance Area Reclaimed 0 Acres
 Area Reclaimed and Fully Released during 2010 0 Acres
 Total Disturbed Area at the end of 2010 9.9 Acres
 Permitted/Bonded Acreage 50.0 Acres
 *Total mine disturbance from the beginning of mining operations through the end of 2009.
6. Briefly describe the reclamation work performed during the past year. (Submit form MR-SITE (https://fs.ogm.utah.gov/pub/mines/minerals_related/forms/MR_SITE.pdf) to apply for full or partial bond/site release). Attach additional sheets if needed.
None. No activity of any kind took place at this site in 2010
7. For large mines, include an updated map depicting surface disturbance and reclamation performed during the year (Rule R647-4-105).

I hereby certify, under penalties of law, the information provided in this report is true and correct to the best of my knowledge and belief.

Name (Typed or Print): John Herwit
 Title of Operator: Asst. Plt. Mgr.
 Signature of Operator: [Signature]
 Date: 1-28-11

RECEIVED

JAN 31 2011

20107


2010 MR-AR Map.

Five Mile Pass, M/450/006

Pabco Building Products, LLC. dba Interstate Brick




Scale 1:8,000

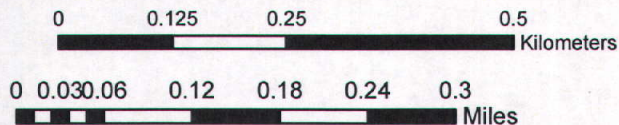

Legend

- Access from stockpile to hwy 73 - .6 miles
- All_Five_Mile_property
- permitted boundary
- ▨ Area worked in 2008 mining - last mining done
- Fivemile Clay Stockpile
- Approx pit boundary, unchanged from 2006

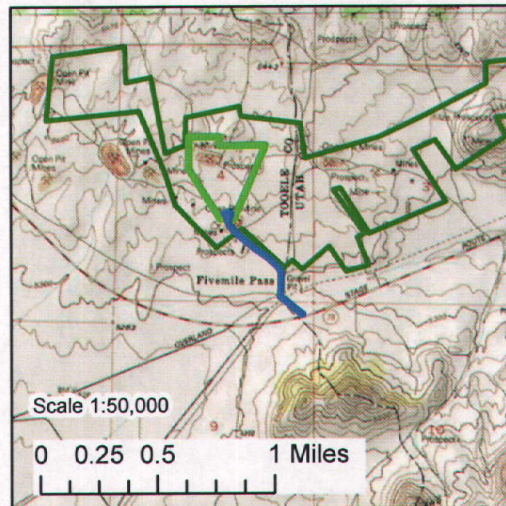

Scale 1:50,000

0 0.25 0.5 1 Miles

T. 7 S., R. 3 W., Sec. 4, SLBM
Five Mile Pass USGS Topo Map